


LABOR AND MATERIALS

1	Copper	} Connection	1 1/2"	\$ 12.37
	Lead			
1	Curb	} Cock Valve T.S. & V.	1 1/2 in.	\$ 13.45
1	Service box		} Short 3 1/2 x 4 1/2 Long 4 1/2 x 5 1/2 Buff or Rdway	
	Old returned			
8	Ft. 1 1/2 in.	} Copper G.I. C.I.	Pipe at 79	\$ 6.32
	Nipples	in. at		\$
	Bushings	to in. at		\$
	Red'g	} Coupl'gs	to in. at	\$
	Inc'g			
	Union	in. at		\$
	Meter	in. at		\$
	Lead Joints	at		\$
	Compound Joints	at		\$
1 1/2	Maintenance Foreman	1937		\$ 2.91 <sup>2702</sup>
	Hrs. Water Maint. Man-1	at		\$
2 1/2	Hrs. Water Maint. Man-2	at 1.613		\$ 13.71
	Hrs. Garage Foreman	at		\$
8	Hrs. Labor	at 1.30		\$ 10.40
	Hrs. Compressor	at		\$
	Compensation Ins. at	\$ 56.86 per C		\$ 1.54
	Trucking			\$ 1.50
	Pav't Patch			\$ 10.80
	Tap by Giesgard & Peterson			\$
				\$
	O'head			\$
				\$ 84.20

St. Pine  
Pl. 16  
Ave. No. 16

Name of Owner  
Occupied by N.Y. Tel. Co.

Labor and Mat'l. Report May 14 1956

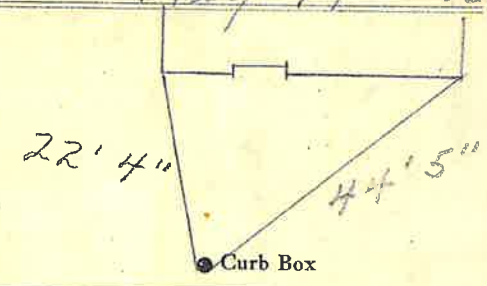

6" Main                      Elev. of Main at tap 5'

Gate at •    • Gate at

TAX ID# 309.28-1-20

• Curb Box