


Labor and Materials

1	Copper } Connection	3 1/2"	\$	320
1	Lead } Cock			
1	Curb } Valve	3 1/4" in.	\$	100
		T. S. & V.		
1	Service Box } Short 3 1/2 x 4 1/2		\$	130
	Old returned } Long 4 1/2 x 5 1/2			
		Buff. or Rdway		
8	Ft. 3/4" in. } Copper		\$	176
		Galv. Iron		
		Cast Iron		
	Nipples	in. at	\$	
	Bushings	to in. at	\$	
	Red'g } Couplings	to in. at	\$	
	Inc'g }			
	Union	in. at	\$	
	Meter	in. at	\$	
	Lbs. Br. Stone	at	\$	
	Lbs. Sand	at	\$	
	Bags Cement	at	\$	
	Paving Brick } Mack		\$	
		Red		
		Asphalt		
	Lead Joints	at	\$	
	Leadite Joints	at	\$	
2	Hrs. Foreman	at 6 2/2	\$	125
7	Hrs. Common Labor	at 5-8	\$	350
	Hrs. Common Labor	at	\$	
	Hrs. Mason	at	\$	
	Hrs. Mason's Helper	at	\$	
	Hrs. Compressor	at	\$	
	Compensation Ins.		\$	13
1/2	Trucking		\$	1.00
N.D.	Builders' Use of Water		\$	
			Total	\$1314

27-21

Labor and Material Report Apr 20 19 27

3rd tap at 22 Pine st

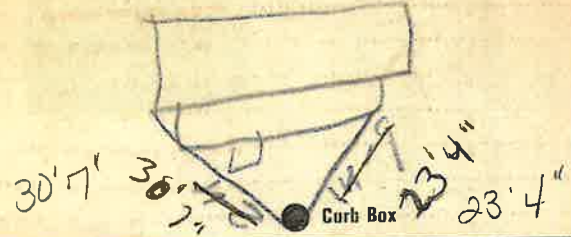

6 Main Elev. of Main at tap 44

Gate at ● Gate at ●

● Curb Box
Old tap shut off

TAX ID# 309.28-1-23