

LABOR AND MATERIALS

Copper	} Connection	_____	\$ _____	
Lead				
Curb	} Cock } Valve } T.S. & V.	_____ in.	\$ _____	
Service box		} Short 3½ x 4½ } Long 4½ x 5½	_____	\$ _____
Old returned				
Ft. 1½ in.	} Copper } G.I. } G.I.	Pipe at _____	\$ _____	
Nipples		_____ in. at _____	\$ _____	
Bushings		_____ to _____ in. at _____	\$ _____	
Red'g	} Coupl'gs	_____ to _____ in. at _____	\$ _____	
Inc'g				
Union	_____ in. at _____	\$ _____		
Meter	_____ in. at _____	\$ _____		
Compound Joints	at _____	\$ _____		
Maintenance Foreman	_____	\$ _____		
Hrs. Water Maint. Man-1	at _____	\$ _____		
Hrs. Water Maint. Man-2	at _____	\$ _____		
Hrs. Garage Foreman	at _____	\$ _____		
Hrs. Labor	at _____	\$ _____		
Hrs. Compressor	at _____	\$ _____		
Trucking	_____	\$ _____		
Pav't Patch	_____	\$ _____		
		\$ _____		
		\$ _____		
		\$ _____		
		\$ _____		


PINE

St. _____
Pl. _____
Ave. No. 23

Name of Owner _____

Labor and Mat'l. Report _____

1989

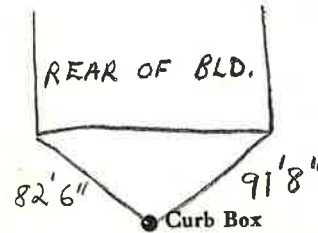

PINE ST.

Main

Elev. of
Main at tap _____

Gate at ●

● Gate at

● Curb Box

CURB BOX IN DRIVEWAY