

LABOR AND MATERIALS


1	Copper	Connection	3/4		\$ 2.80
	Lead				3.60
1	Curb	Clock Valve	3/4	in.	\$
		T. S. & V.			
1	Service box	Short 3 1/2 X 4 1/2			\$ 5.80
	Old returned	Long 4 1/2 X 5 1/2			
		Buffer Rdway			
14	Ft.	Copper		Pipe at	\$ 4.90
		Galv. Iron			
		Cast Iron			
	Nipples	in. at			\$
	Bushings	to		in. at	\$
	Red'g Inc'g	Couplings	to	in. at	\$
	Union	in. at			\$
	Meter	in. at			\$
	Lead Joints	at			\$
	Compound Joints	at			\$
	Hrs. Foreman	at			\$
	Hrs. Chauffeur	at			\$
3	Hrs. Tapper	at	91		\$ 2.73
15	Hrs. Labor	at	80		\$ 12.00
	Hrs. Labor	at			\$
	Hrs. Compressor	at			\$
	Compensation Ins.				\$ 33
	Trucking				\$ 1.50
	Builders Use of Water				\$ 5.80
	Tap by 1999 water				\$
					\$
					\$
					\$
					\$
					\$ 38.96

156-47

St. _____
Pl. _____
Ave. No. 28

Name of Owner
Pine
Thomson

Labor and Mat'l. Report Nov. 20 1947

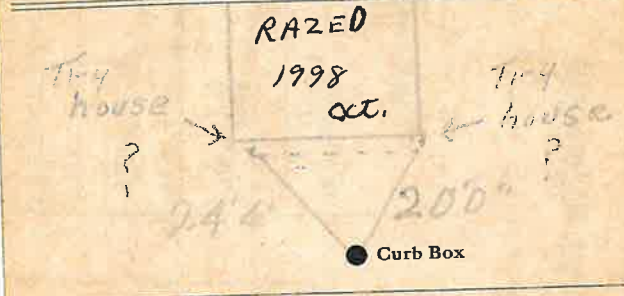

8 Main Elev. of Main at tap 7
Gate at ● Gate at ●

● Curb Box