

Labor and Materials

Copper	} Connection.....	3	\$. 1.33
Lead			
Curb	} Cock Valve P.S.&V. }	4	\$. 1.58
Service Box	} Short 3 1/2 x 4 1/2 Long 4 1/2 x 6 1/2 Buff or Rdway }	4	\$. 1.36
Old returned			
23 Ft.	} Copper Galv. Iron Cast Iron }	3	\$. 2.09
in.			
Nipples	in. at		\$
Bushings	to	in. at	\$
Red'g Inc'g	} Couplings.....	to	in. at
Union	in. at		\$
Meter	in. at		\$
Lbs. Br. Stone	at		\$
Lbs. Sand	at		\$
Bags Cement	at		\$
Paving Brick	} Mack Red Asphalt }	at	\$
Lead Joints			
Leadite Joints			
3 Hrs.	Foreman	at	\$. 1.88
4 Hrs.	Common Labor	at	\$. 4-
5 Hrs.	Common Labor	at	\$. 2.25
Hrs.	Mason	at	\$
Hrs.	Masons Helper	at	\$
Hrs.	Compressor	at	\$
Compensation	Ins		\$. 2.5
Trucking			\$. 1-
Builders Use of Water			\$. 5-


Total \$ 20.74

33-27

Labor and Material Report

June 5 1937

5 Pine 07

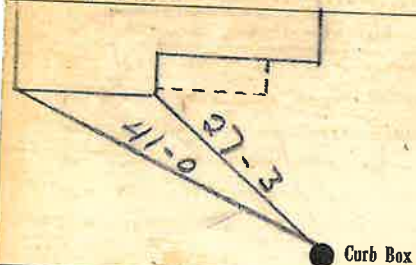

6 Main

Elev. of  
Main at tap

Gate at

TAX ID # 302.20-22-5 Gate at

Curb Box

old Tap to be dug up

*[Signature]*