

Labor and Materials


1	Copper	{ Connection	?	\$ 3.20
1	Curb	{ Cock Valve T. S. & V.	9 3/4	\$ 1.00
1	Service Box	{ Short 3/4 x 1/2		\$ 1.30
	Old returned	{ Short 3/4 x 1/2 part of Redway		
1 1/2	Ft.	{ Copper Galv. Iron Cast Iron	3 1/4	\$ 2.42
	Nipples	in. at		\$
	Bushings	to in. at		\$
	Red'g Inc'g	Couplings to in. at		\$
	Union	in. at		\$
	Meter	in. at		\$
	Lbs. Br. Stone	at		\$
	Lbs. Sand	at		\$
	Bags Cement	'at		\$
	Paving Brick	{ Mack Red Asphalt } at		\$
	Lead Joints	at		\$
	Leadite Joints	at		\$
3	Hrs. Foreman	at	6 2/3	\$ 1.88
1 1/2	Hrs. Common Labor	at	4 2/3	\$ 4.88
	Hrs. Common Labor	at		\$
	Hrs. Mason	at		\$
	Hrs. Mason's Helper	at		\$
	Hrs. Compressor	at		\$
	Compensation Ins.		1 1/2	\$ 1.8
	Trucking			\$ 1.00
	Builders' Use of Water			\$
Total				\$ 15.86

28-102

Labor and Material Report

16 1928

6 Pine

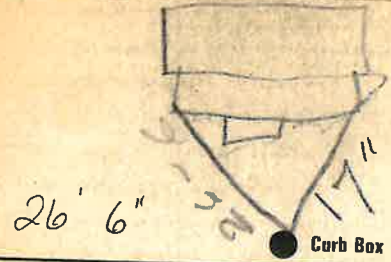

6" Main

Elev of Main at tap 5

Gate at TAX ID # 302.20-27-11 Gate at

● Curb Box

Old tap shut off


LABOR AND MATERIALS

Copper } Connection _____	\$ _____
Lead } _____	\$ _____
Curb } Cock _____	in. _____ \$ _____
Valve } _____	
T.S. & V. } _____	
Service box { Short 3-1/2 x 4-1/2 } _____	\$ _____
Old returned { Long 4-1/2 x 5-1/2 } _____	\$ _____
Ft. _____ in. { Copper } Pipe at _____	\$ _____
{ G.I. } _____	
{ C.I. } _____	
Nipples _____ in. at _____	\$ _____
Bushings _____ to _____ in. at _____	\$ _____
Red'g _____	\$ _____
Inc'g _____	\$ _____
Union _____ in. at _____	\$ _____
Meter _____ in. at _____	\$ _____
_____	\$ _____
Compound Joints at _____	\$ _____
Maintenance Foreman _____	\$ _____
Hrs. Water Maint. Man - 1 at _____	\$ _____
Hrs. Water Maint. Man - 2 at _____	\$ _____
Hrs. Garage Foreman _____ at _____	\$ _____
Hrs. Labor _____ at _____	\$ _____
Hrs. Compressor at _____	\$ _____
_____	\$ _____
Trucking _____	\$ _____
Pav't Patch _____	\$ _____
_____	\$ _____
_____	\$ _____
_____	\$ _____
_____	\$ _____

OUTSIDE CLEAN OUT
 ST. R. Ave. No. _____

Name of Owner
 6 Pine ST.

Labor and Mat'l. Report 19

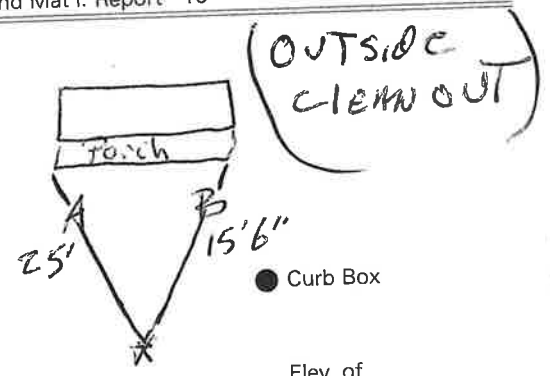

OUTSIDE CLEAN OUT

● Curb Box

_____ Main Elev. of Main at tap _____
 Gate at ● Gate at ●

● Curb Box

6" Cleanout 4" Plastic From Hole

* ONLY Run towards Main!