

Labor and Materials


1	Copper } Connection.....	3	\$ 2.60
	Lead }		
1	Curb } Cock Valve }	1	\$ 2.27
	} T. S. & V. }		
1	Service Box } Short 3/4x1 1/2 }		\$ 1.35
	Old returned } Long 1 1/2x5/8 }		
	} Butt. or Redway }		
12	Ft. } in. } Copper } Pipe at.....	4	\$ 2.16
	} } Galv. Iron }		
	} } Cast Iron }		
	Nipples..... in. at.....		\$
	Bushings..... to..... in. at.....		\$
	Red'g } Couplings..... to..... in. at.....		\$
	Inc'g }		
	Union..... in. at.....		\$
	Meter..... in. at.....		\$
	Lbs. Br. Stone at.....		\$
	Lbs. Sand at.....		\$
	Bags Cement 'at.....		\$
	Paving Brick } Mack } at.....		\$
	} Red }		
	} Asphalt }		
	Lead Joints at.....		\$
	Leadite Joints at.....		\$
2	Hrs. Foreman at.....		\$ 1.25
9	Hrs. Common Labor at.....	Tapper	\$ 4.50
9	Hrs. Common Labor at.....	Killer	\$ 4.05
	Hrs Mason at.....		\$
	Hrs Mason's Helper at.....		\$
	Hrs. Compressor at.....		\$
	Compensation Ins.....		\$ 30
	Trucking.....		\$ 1.-
	Builders' Use of Water.....	Patrick	\$ 5.-
Total \$			24.51

31-228

Labor and Material Report

Nov. 9 1963

10 Pine St.

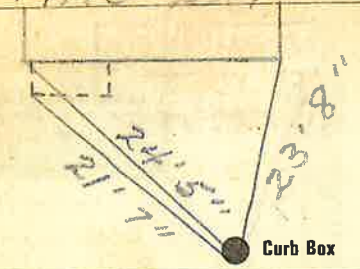

1963

6 Main Elev of Main at tap 5
 Gate at TAX # 10 # 302.20-27-13 Gate at

● Curb Box

old Tap dug up
 + shut off. at SEWER
 main OUT SIDE
 CLEAN OUT
 4-27-2004

