


Labor and Materials

Copper	Connection	3	\$ 3.20
Lead			
Curb	Cock	3	\$ 1.00
	Value		
	T.S. & V.	4	\$ 1.40
Service Box	Short 4x4 1/2		
Old returned	Long 4 1/2 x 5 1/2		
	Buff. or Rdway		
12 Ft.	Copper	3	\$ 2.64
	Galv. Iron	4	
	Cast Iron		
	Pipe at		
	Nipples		
	Bushings		
	Red'g		
	Inc'g		
	Couplings		
	Union		
	Meter		
	Lbs. Br. Stone at		
	Lbs. Sand at		
	Bags Cement at		
	Paving Brick		
	Mack		
	Red		
	Asphalt		
	Lead Joints at		
	Leadite Joints at		
2	Hrs. Foreman at		\$ 1.25
	Hrs. Common Labor at		
13	Hrs. Common Labor at		\$ 5.28
	Hrs. Mason at		
	Hrs. Mason's Helper at		
	Hrs. Compressor at		
	Compensation Ins		\$ 1.7
	Trucking		\$ 1.00
	Builders' Use of Water		
Total \$			15.94

28-136 16 Labor and Material Report Oct 2 1928

12 Platts

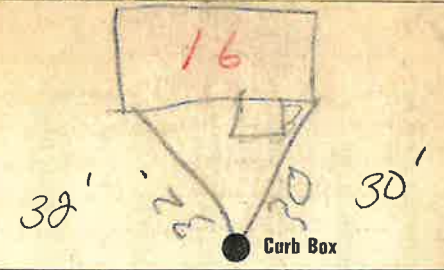

Main Eley of Main at tap 5 1/2
Gate at ● Gate at ●

● Curb Box

old Tap Shut off
TAX ID# 303.18-12-4