

Labor and Materials

Copper } Connection.....		\$ 1.25
Lead }		
Curb { Cock Valve }	in	\$ 1.70
	2 S.C.V.	
Service Box { Short 2 1/2 x 4 1/2 }		\$ 1.45
Old returned { Long 4 1/2 x 5 1/2 }		
	Buff. or Rdway	
7 Ft. 3/4 in. { Copper } Pipe at 12 1/2		\$ 95
	Galv. Iron	
	Cast Iron	
Nipples	in. at	\$
Bushings	to	in. at \$
Red'g } Couplings.....	to	in. at \$
Inc'g }		
Union.....	in. at	\$
Meter.....	in. at	\$
Lbs. Br. Stone at		\$
Lbs. Sand at		\$
Bags Cement at		\$
Paving Brick { Mack } at		\$
	Red	
	Asphalt	
Lead Joints at		\$
Leadite Joints at		\$
9 Hrs. Foreman at	67 1/2	\$ 5.63
15 Hrs. Common Labor at	50	\$ 5.-
24 Hrs. Common Labor at	45	\$ 11.70
Hrs. Mason at		\$
Hrs. Masons Helper at		\$
5 Hrs. Compressor at	1 50	\$ 7.50
Compensation Ins		\$ 84
Trucking		\$ 1.-
Builders Use of Water ..	Patch	\$ 5.-
Total		\$ 202


1935-28

2.6

Labor and Material Report

Feb. 27 1935

22 Pfall St.

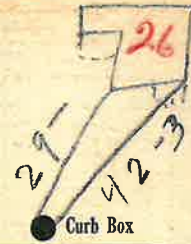

4 Main

Elev. of Main at tap 5

Gate at ●

● Gate at

● Curb Box

old shut off at main

to be charged.

TAX ID# 303.18.6-1

[Handwritten signature]