


### Labor and Materials

1	Lead Connection	3		\$
1	Curb Cock	3		\$
1	Service Box	{ Short 4 x 4 }		\$
	Old returned	{ Long 4 x 5 }		\$
27	Ft. in. G. I. Pipe at	3		\$
	Nipples		in. at	\$
1	Bushings	3	to in. at	\$
1	Red'g Coup.	3	to in. at	\$
	Inc'g Coup.	1	to in. at	\$
	Union		in. at	\$
	Meter		in. at	\$
	Cu. Yds. Br. Stone at			\$
	Cu. Yds. Sand at			\$
	Bags Cement at			\$
	Paving Brick	{ Mack Red Asphalt }	at	\$
19	Hrs. Foreman at			\$
	Hrs. Common Labor at			\$
	Hrs. Mason at			\$
2	Hrs.	penor	at	\$
	Hrs.		at	\$
No	Builders' Use of Water			\$
	Truck		at	\$ 1.00
			at	\$
			at	\$
			at	\$
	Total		\$	14.39

27 Platte St.

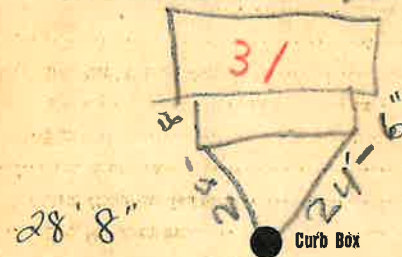

6 Main Elev. of Main at tap 43  
Gate at ● Gate at ●

● Curb Box

TAX ID # 303.18-7-18