


**Labor and Materials**

1. Lead Connection .....	\$.
1. Curb Cock .....	\$.
1. Service Box (Short 3 1/2 x 4 1/2) Old returned Long 3 1/2 x 6 1/2 Buffalo	\$.
8. Ft. 1/2 in. Pipe at .....	\$.
Nipples .. in. at .....	\$.
1. Bushings .. to 1/2 in. at .....	\$.
Red'g Coup .. to .. in. at .....	\$.
Inc'g Coup .. to .. in. at .....	\$.
Union .. in. at .....	\$.
Meter .. in. at .....	\$.
Cu. Yds. Br. Stone at .....	\$.
Cu. Yds. Sand at .....	\$.
Bags Cement at .....	\$.
Paving Brick { Mack Red Asphalt } at .....	\$.
1. Hrs. Foreman at .....	\$.
9. Hrs. Common Labor at .....	\$.
Hrs. Mason at .....	\$.
Hrs. .... at .....	\$.
Hrs. .... at .....	\$.
no. Builders' Use of Water .....	\$.
Trucks 1.00 .....	\$.
..... at .....	\$.
..... at .....	\$.
..... at .....	\$.
Total \$ .....	\$.

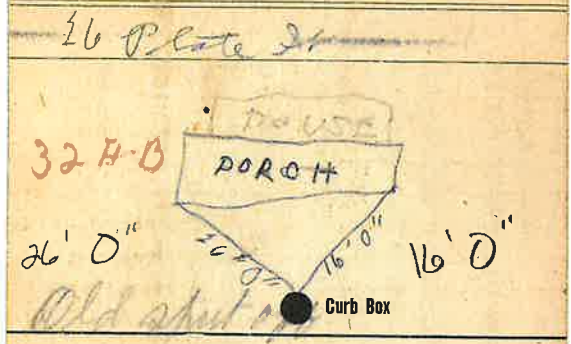

6 Main Elev. of Main at tap 6

Gate at ● Gate at ●

● Curb Box

TAX ID# 303.18-6-2