


Labor and Materials

1	Copper } Connection	\$ 3.20
	Lead } "	
	Curb } Cock Valve } in	\$ 1.00
		T. S. & V. }
	Service Box } Short 3" x 4"	\$ 1.30
	Old returned } Long 4" x 5"	
		Buff. or Rdway }
6	Ft. 4 in. } Copper Galv. Iron } Pipe at	\$ 1.32
		Cast Iron }
	Nipples..... in. at.....	\$
	Bushings..... to..... in. at.....	\$
	Red'g } Couplings..... to..... in. at.....	\$
	Inc'g } "	
	Union..... in. at.....	\$
	Meter..... in. at.....	\$
	Lbs. Br. Stone at.....	\$
	Lbs. Sand at.....	\$
	Bags Cement at.....	\$
	Paving Brick } Mack } at	\$
		Red }
		Asphalt }
	Lead Joints at.....	\$
	Leadite Joints at.....	\$
1	Hrs. Foreman at.....	\$ 1.63
8	Hrs. Common Labor at.....	\$ 4.00
	Hrs. Common Labor at.....	\$
	Hrs. Mason at.....	\$
	Hrs. Mason's Helper at.....	\$
	Hrs. Compressor at.....	\$
	Compensation Ins.....	\$ 1.12
	Trucking.....	\$ 1.00
	Builders' Use of Water.....	\$
	Total	\$ 12.54

27-136 39 Labor and Material Report Aug 18 1917

28 Blott st

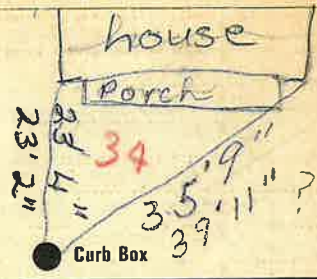

6 Main Elev. of Main at tap 5

Gate at ● Gate at ●

● Curb Box

Glen Joseph
865

TAX ID# 303.18-6-3