


Labor and Materials

Copper } Connection.....	3	\$ 1.50
Lead }		
Curb { Cock Valve P.S.S.W. }	in 3/4	\$ 1.70
Service Box Old returned	Sheet 3 1/2 x 4 1/2 Long 4 1/2 x 5 1/2 Duff	\$ 1.50
26 Ft. 3/4 in. { Copper Cast Iron Cast Iron } Pipe at		\$ 4.94
Nipples	in. at	\$
Bushings	to in. at	\$
Red'g Inc'g } Couplings.....	to in. at	\$
Union.....	in. at	\$
Meter.....	in. at	\$
Lbs. Br. Stone at		\$
Lbs. Sand at		\$
Bags Cement at		\$
Paving Brick { Mack Red Asphalt }	at	\$
Lead Joints at		\$
Leadite Joints at		\$
4 Hrs. Foreman at	6 1/2	\$ 2.50
4 Hrs. Common Labor at	50	\$ 2.00
8 Hrs. Common Labor at	45	\$ 3.60
Hrs. Mason at		\$
Hrs. Masons Helper at		\$
Hrs. Compressor at		\$
Compensation Ins		\$ 6.29
Trucking		\$ 1.12
Builders Use of Water	Paint Patch	\$ 5.00
Total		\$ 24.07

49 34 35-
Labor and Material Report Aug 1 1934

31 Platt St

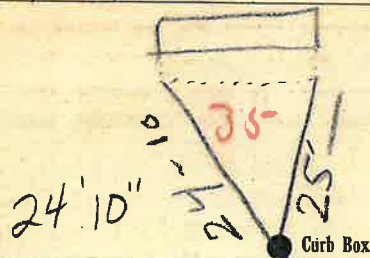

6 Main

Elev. of Main at tap 5 1/2

Gate at ●

● Gate at

● Curb Box

old type shed off at
train
TAX ID# 303.18-7-16.1

VAM

DMD