

LABOR AND MATERIALS

1 Copper Lead Connection	3/4	\$	1.35
1 Curb Cock Valve F.S. & V.	3/4 in.	\$	1.80
1 Service Box Old returned	{ Short 3 1/2 x 4 3/4 Long 4 1/2 x 5 1/2 Buffer Rdway }	\$	1.70
27 Ft. 3/4 in. Copper Galv. Iron Cast Iron Pipe at	18	\$	4.86
Nipples	in. at	\$	
Bushings	to in. at	\$	
Red'g Inc'g	Couplings to in. at	\$	
Union	in. at	\$	
Meter	in. at	\$	
Lead Joints at		\$	
Leadite Joints at		\$	
Hrs. Foreman at		\$	
3 Hrs. Chauffeur at	6 1/2	\$	1.88
8 1/2 Hrs. Tapper at		\$	5.31
12 1/2 Hrs. Labor at	45	\$	5.63
Hrs. Labor at		\$	
3/4 Hrs. Compressor at	6 1/2	\$.46
Compensation Ins.		\$.39
Trucking		\$	1.00
Builders Use of Water	Before Paving	\$	—
Tap by Hessel		\$	—
		\$	
		\$	
		\$	
		\$	
		\$	24.38

104 1941


St. 37
Pl.
Ave. No. 31A

Platt

Name of Owner

Rev. T. D. Vachot

Labor and Mat'l. Report Aug 28 1941

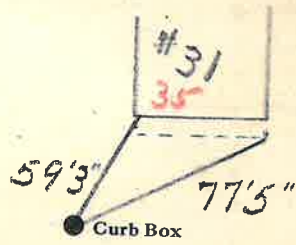

6 Main

Elev. of Main at tap 5

Gate at • Gate at
TAX ID # 303.18-7-16.2

• Curb Box