

1 0 6 1941

Platt

St. 40  
Pl. 32  
Ave. No. 32


Name of Owner

Edw Maginn

Labor and Mat'l. Report

Aug

1941

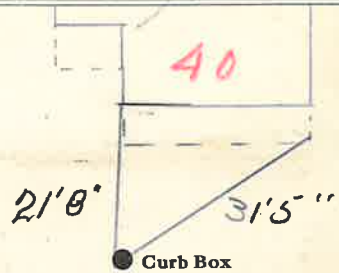

6 Main

Elev. of Main at tap 5

Gate at ●

● Gate at

● Curb Box


PLATT

St. 40  
Pl. 40  
Ave. No. 40

Name of Owner

Labor and Mat'l. Report

12/13/12

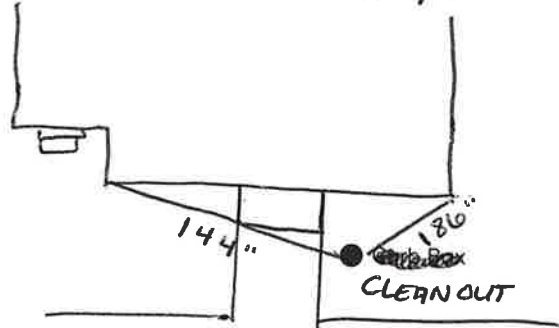

Main

Elev. of Main at tap

Gate at ●

● Gate at

TAX ID# 303.18-6-5

● Curb Box

