

LABOR AND MATERIALS

✓ Copper } Connection $\frac{3}{4}$ \$ 1.35
 Lead }
 1 Curb { Cock Valve } $\frac{3}{4}$ in. \$ 1.80
 T-S-&V. }
 1 Service Box } Short $3\frac{1}{2} \times 4\frac{1}{2}$ }
 Old returned } Long $4\frac{1}{2} \times 5\frac{1}{2}$ } \$ 1.70
 Buffer Rdway }
 8 Ft. $\frac{3}{4}$ in. } Copper } Pipe at 18 \$ 1.44
 Galv. Iron }
 Cast Iron }
 Nipples..... in. at \$
 Bushings to in. at \$
 Red'g } Couplings to in. at \$
 Inc'g }
 Union in. at \$
 Meter in. at \$
 Lead Joints at \$
 Leadite Joints at \$
 Hrs. Foreman at \$
 1 Hrs. Chauffeur at $6\frac{1}{2}$ \$ 6.2
 3 Hrs. Tapper at 7 \$ 1.85
 4 Hrs. Labor at $4\frac{1}{2}$ \$ 1.80
 Hrs. Labor at \$
 3.4 Hrs. Compressor at $6\frac{1}{2}$ \$ 4.6
 Compensation Ins. \$ 1.4
 Trucking \$ 1.-
 Builders Use of Water By \$
 Tap by Hesse \$
 \$ 12.19


108, 1941

St. 48
 Pl. 38
 Ave. No.

Platt St

Name of Owner
 Moncrian Sect Tap

Labor and Mat'l. Report Aug. 4 1941

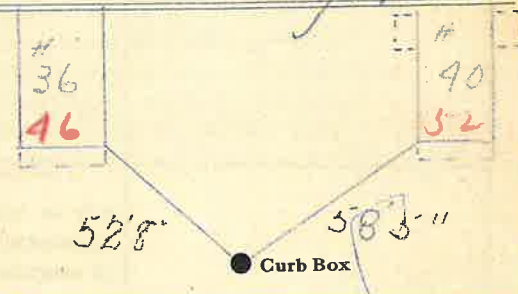

12"-1969

6 Main Elev. of Main at tap 6

Gate at ● Gate at ●

TAX # 303.18-6-8

● Curb Box