


Labor and Materials

1	Copper } Connection.....		\$ 3.20
	Lead		
1	Curb { Cock Valve }.....in.	3 1/2	\$ 1.00
	T. S. & V.		
1	Service Box { Sheet 21 x 44 }.....		\$ 1.40
	Old returned Long 4 1/2 x 5 1/2		
	Off or Rdway		
26	Ft.....in. { Copper Galv. Iron } Pipe at.....		\$ 5.72
	Cast Iron		
	Nipples.....in. at.....		\$
	Bushings.....to.....in. at.....		\$
	Red'g } Couplings.....to.....in. at.....		\$
	Inc'g		
	Union.....in. at.....		\$
	Meter.....in. at.....		\$
	Lbs. Br. Stone at.....		\$
	Lbs. Sand at.....		\$
	Bags Cement at.....		\$
	Paving Brick { Mack Red Asphalt } at.....		\$
	Lead Joints at.....		\$
	Leadite Joints at.....		\$
3	Hrs. Foreman at.....	62.5	\$ 188
	Hrs. Common Labor at.....		\$
26	Hrs. Common Labor at.....	70 5/8	\$ 105.76
	Hrs. Mason at.....		\$
	Hrs. Mason's Helper at.....		\$
	Hrs. Compressor at.....		\$
	Compensation Ins.....		\$ 33
	Trucking.....		\$ 1.00
	Builders' Use of Water.....		\$
Total			\$ 250.9

27-115 49
 Labor and Material Report Sept 17 19 26

37 Plate SW

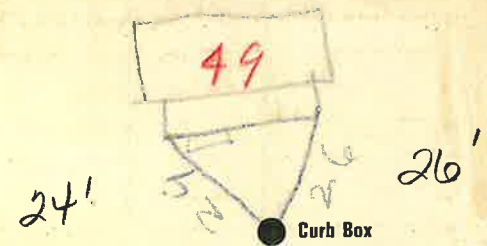

12"-1969

Main Elev. of Main at tap 6

Gate at TAX ID # 303.18-2-21 Gate at

Curb Box

Old connection still connected to 35 Plate SW