


PLATT ST St.  
Pl. Ave. No. 31


Name of Owner

Labor and Mat'l. Report 19

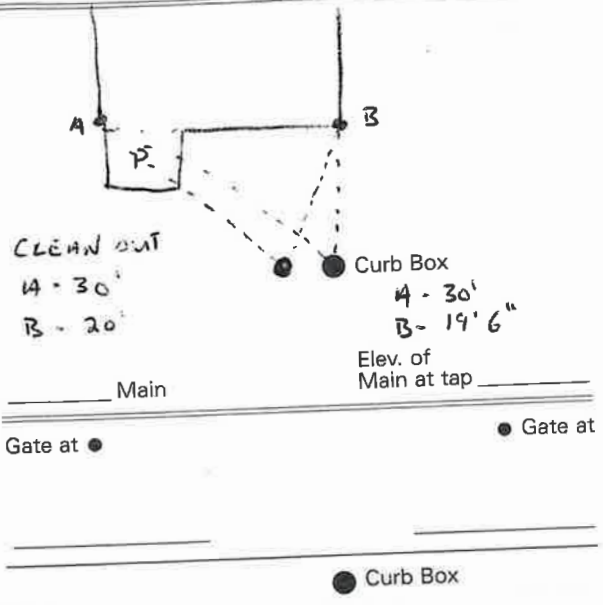

51 June 9 1951  
Labor and Material Report

39 Platt St.

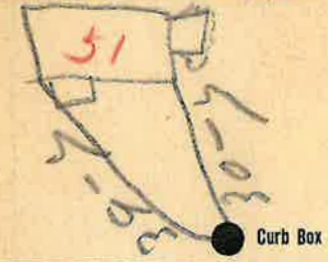

12" 1969  
Main Elev. of Main at tap 6

Gate at ● Gate at ●  
TAX ID # 303.18-2-20

● Curb Box  
old connection  
Dug up + shut off  
INSTALLED OUTSIDE  
CLEAN OUT 8/5/09

