


Labor and Materials

Copper	Connection	3	\$ 320
Curb	Cock Valve T. S. & V.	4	\$ 100
Service Box	Short 3 1/2 x 4 1/2	4	\$ 120
Old returned	Buff or Rdway		
9 Ft.	Copper Pipe at	3 1/2	\$ 198
Nipples	Cast Iron		
Bushings	to in. at		\$
Red'g Inc'g	Couplings to in. at		\$
Union	in. at		\$
Meter	in. at		\$
Lbs. Br. Stone	at		\$
Lbs. Sand	at		\$
Bags Cement	at		\$
Paving Brick	Mack Red Asphalt at		\$
Lead Joints	at		\$
Leadite Joints	at		\$
5 Hrs.	Foreman at		\$ 188
1 1/2 Hrs.	Common Labor at		\$ 44.7
Hrs.	Common Labor at		\$
Hrs.	Mason at		\$
Hrs.	Mason's Helper at		\$
Hrs.	Compressor at		\$
Compensation	Ins	17	\$
Trucking		100	\$
Builders' Use of Water			\$
Total \$			1500

Labor and Material Report

28-86 62 July 25 1925
48 Platt St

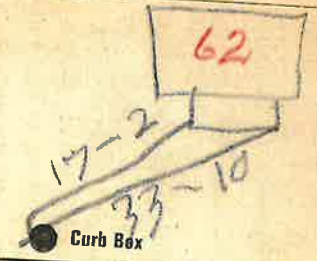

6 Main Elev of Main at tap 5
Gate at Gate at

● Curb Box

old top
shutoff

TAX ID # 303.18-1-2