

LABOR AND MATERIALS


| | | | | | |
|---|----------------------------|------------------------|---------|----|-------|
| 1 | Copper | { Connection | 3/4 | \$ | 2.29 |
| 1 | Lead | { | | | |
| 1 | Curb | { Cock Valve F.S. & V. | 3/4 in. | \$ | 2.70 |
| 1 | Service box | { Short 3 1/2 x 4 1/2 | | \$ | 4.25 |
| | Old returned | { Long 4 1/2 x 5 1/2 | | | |
| | | { Buff or Rdway | | \$ | |
| 7 | Ft. 3/4 in. | { Copper | | \$ | 2.45 |
| | | { G.I. | | | |
| | | { C.I. | | | |
| | Nipples | in. at | | \$ | |
| | Bushings | to in. at | | \$ | |
| | Red'g Inc'g | { Coupl'gs to in. at | | \$ | |
| | Union | in. at | | \$ | |
| | Meter | in. at | | \$ | |
| | Lead Joints at | | | \$ | |
| | Compound Joints at | | | \$ | |
| | Hrs. Water Maint. Man-1 at | | | \$ | |
| 3 | Hrs. Water Maint. Man-2 at | 1.02 | | \$ | 3.06 |
| 7 | Hrs. Labor at | 91 | | \$ | 6.37 |
| | Hrs. Labor at | | | \$ | |
| | Hrs. Compressor at | | | \$ | |
| | Compensation Ins. at \$ | | per C. | \$ | .21 |
| | Trucking | | | \$ | 1.02 |
| | Pav't Patch | | | \$ | 8.78 |
| | Top of Main | | | \$ | |
| | O'head | | | \$ | |
| | | | | \$ | 31.11 |

501930

Platt St St. Pl. Ave. No. 66

Name of Owner
Ketchum

Labor and Mat'l. Report May 31 19 50

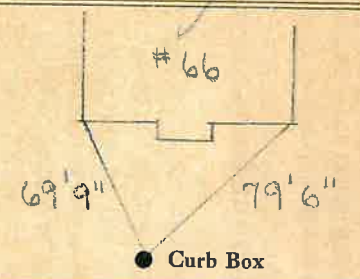

6" Main Elev. of Main at tap 4'

Gate at • Gate at
TAX ID # 303.18-1-3

• Curb Box