


LABOR AND MATERIALS

1 Copper } Connection 3/4" \$ \_\_\_\_\_  
 Lead }  
 1 Curb } Cock } 3/4 in. Oriscat \$ \_\_\_\_\_  
 Valve }  
 T.S. & V. }  
 1 Service box { Short 3 1/2 x 4 1/2 }  
 Old returned { Long 4 1/2 x 5 1/2 } \$ \_\_\_\_\_  
 Buff or Rdway }  
 16 Ft 3/4 in. { Copper } Pipe at \_\_\_\_\_ \$ \_\_\_\_\_  
 { G.I. }  
 { C.I. }  
 Nipples \_\_\_\_\_ in. at \_\_\_\_\_ \$ \_\_\_\_\_  
 Bushings \_\_\_\_\_ to \_\_\_\_\_ in. at \_\_\_\_\_ \$ \_\_\_\_\_  
 Red'g }  
 Inc'g } Coupl'gs \_\_\_\_\_ to \_\_\_\_\_ in. at \_\_\_\_\_ \$ \_\_\_\_\_  
 Union \_\_\_\_\_ in. at \_\_\_\_\_ \$ \_\_\_\_\_  
 Meter \_\_\_\_\_ in. at \_\_\_\_\_ \$ \_\_\_\_\_  
 Lead Joints at \_\_\_\_\_ \$ \_\_\_\_\_  
 Compound Joints at \_\_\_\_\_ \$ \_\_\_\_\_  
 Maintenance Foreman \_\_\_\_\_ \$ \_\_\_\_\_  
 Hrs. Water Maint. Man-1 at \_\_\_\_\_ \$ \_\_\_\_\_  
 Hrs. Water Maint. Man-2 at \_\_\_\_\_ \$ \_\_\_\_\_  
 Hrs. Garage Foreman \_\_\_\_\_ at \_\_\_\_\_ \$ \_\_\_\_\_  
 Hrs. Labor \_\_\_\_\_ at \_\_\_\_\_ \$ \_\_\_\_\_  
 Hrs. Compressor at \_\_\_\_\_ \$ \_\_\_\_\_  
 Compensation Ins. at \$ \_\_\_\_\_ per C \_\_\_\_\_ \$ \_\_\_\_\_  
 Trucking \_\_\_\_\_ \$ \_\_\_\_\_  
 Pav't Patch \_\_\_\_\_ \$ \_\_\_\_\_  
Tap by Gifford & Co. \$ \_\_\_\_\_  
8-5-64. \$ \_\_\_\_\_  
 O'head \_\_\_\_\_ \$ \_\_\_\_\_

Platt St. 69  
 Ave. No. 69  
 Name of Owner  
Anthony J. Ricciardelli

Labor and Mat'l. Report Aug. 5 1964.

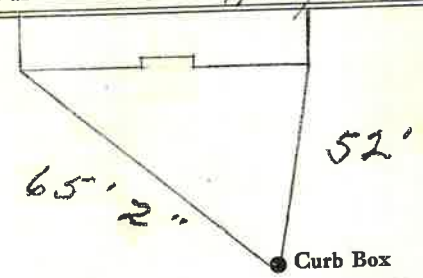

6" Main Elev. of Main at tap 5'  
 Gate at • Gate at •

TAX ID # 303.18-2-6  
 • Curb Box