

### LABOR AND MATERIALS


1 Copper } Connection  $3/4$  ..... \$ 1.35  
   Lead }  
 1 Curb } Cock Valve }  $3/4$  in. ..... \$ 1.80  
       } T. S. & V. }  
 1 Service Box } Short  $3\frac{1}{2} \times 4\frac{1}{2}$  }  
    Old returned } Long  $4\frac{1}{2} \times 5\frac{1}{2}$  } ..... \$ 1.70  
                 } Buffer Rdway }  
 7 Ft.  $3/4$  in. } Copper } Pipe at 18 \$ 126  
                 } Galv Iron }  
                 } Cast Iron }  
 Nipples..... in. at ..... \$  
 Bushings ..... to ..... in. at ..... \$  
 Red'g } Couplings..... to ..... in. at ..... \$  
 Inc'g }  
 Union..... in. at ..... \$  
 Meter..... in. at ..... \$  
 Lead Joints at ..... \$  
 Leadite Joints at ..... \$  
 Hrs. Foreman at ..... \$  
 1 Hrs. Chauffeur at  $62\frac{1}{2}$  ..... \$ 62  
 3 Hrs. Tapper at  $2$  ..... \$ 1.87  
 4 Hrs. Labor at  $45$  ..... \$ 1.80  
 Hrs. Labor at ..... \$  
 3/4 Hrs. Compressor at  $62\frac{1}{2}$  ..... \$ 46  
 Compensation Ins. ..... \$ 14  
 Trucking ..... \$ 1 -  
 Builders Use of Water  $Reford Park$  ..... \$  
   *Tap by Hesser* ..... \$  
   ..... \$  
   ..... \$  
\$ 12.01

107-B  
 St. Platt  
 Ave. No. 4+6

Name of Owner  
*McMahon*

Labor and Mat'l. Report July 20 1941

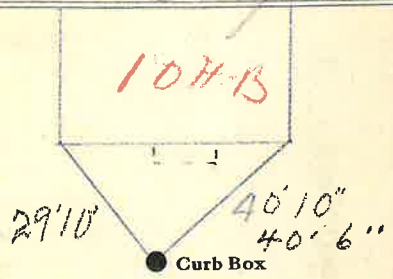

4 Main    Elev. of Main at tap 7

Gate at ●    ● Gate at

TAX ID # 303.18-12-1

● Curb Box