

LABOR AND MATERIALS

Copper	}	Connection	\$	
Lead				
Curb	}	Cock	in.	\$
		Valve		
		T. S. & V.		
Service box	}	Short $3\frac{1}{2} \times 4\frac{1}{2}$		
		Long $4\frac{1}{2} \times 5\frac{1}{2}$		
Old returned			\$	
Ft. $\frac{3}{4}$ in.	}	Copper	Pipe at	\$
		G.I.		
Nipples		in. at	\$	
Bushings		to in. at	\$	
Red'g Inc'g	}	Coupl'gs	to in. at	\$
Union		in. at	\$	
Meter		in. at	\$	
			\$	
Compound Joints		at	\$	
Maintenance Foreman			\$	
Hrs. Water Maint. Man-1		at	\$	
Hrs. Water Maint. Man-2		at	\$	
Hrs. Garage Foreman		at	\$	
Hrs. Labor		at	\$	
Hrs. Compressor		at	\$	
			\$	
Trucking			\$	
Pav't Patch			\$	
			\$	
			\$	
PLATT


St.
~~Pl.~~
Ave. No. 72

Name of Owner

TAYLOR

Labor and Mat'l. Report

1993

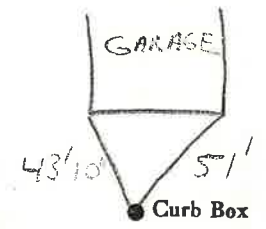

Main

Elev. of
Main at tap

Gate at ●

● Gate at

TAX ID # 303.18-1-5

● Curb Box