

Platt


St. Pl. Ave. No. 73

Name of Owner

Philip DeAngelo

Labor and Mat'l. Report

July 18 1963

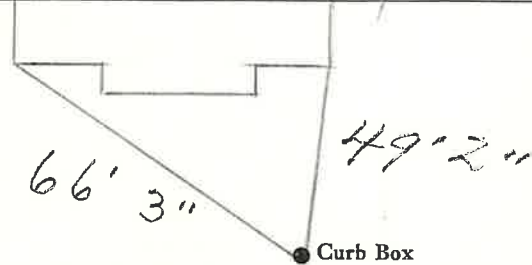

6" C.S.P.
Main

Elev. of Main at tap 5'

Gate at ●

● Gate at

● Curb Box

PLATT

St. Pl. Ave. No. 73

Name of Owner

Labor and Mat'l. Report 19

2 Lines Sewer
REPAIR

● Curb Box

Main

Elev. of Main at tap

Gate at ●

● Gate at

TAX ID# 303.14-3-33

● Curb Box

