


LABOR AND MATERIALS

1	Copper	} Connection	3/4"	\$	
	Lead				
1	Curb	} Cock Valve T. S. & V.	3/4 in. Oriseal	\$	
1	Service box		} Short 3 1/2 x 4 1/2 Long 4 1/2 x 5 1/2 Buff or Rdway	Oriseal	\$
	Old returned				Box.
21	Ft. 3/4 in.	} Copper C.I. C.I.		Pipe at	\$
	Nipples		in. at	\$	
	Bushings		to in. at	\$	
	Red'g Inc'g	} Coupl'gs	to in. at	\$	
	Union		in. at	\$	
	Meter	in. at	\$		
	Lead Joints	at	\$		
	Compound Joints	at	\$		
	Maintenance Foreman		\$		
	Hrs. Water Maint. Man-1	at	\$		
	Hrs. Water Maint. Man-2	at	\$		
	Hrs. Garage Foreman	at	\$		
	Hrs. Labor	at	\$		
	Hrs. Compressor	at	\$		
	Compensation Ins. at \$	per C	\$		
	Trucking		\$		
	Pav't Patch		\$		
	Tap by SEYMOUR,		\$		
	Laveau & Co		\$		
	6-1-70.		\$		
	O'head		\$		
			\$		

St. Platt  
 Ave. No. 74

Name of Owner Clarence Taylor.

Labor and Mat'l. Report June 1 1970

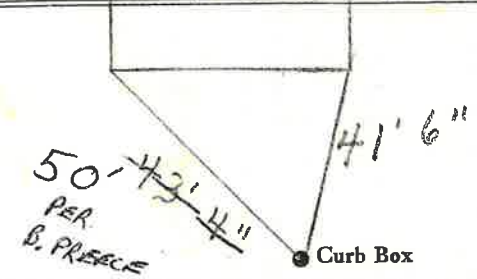

6" Main Elev. of Main at tap 4'

Gate at • Gate at •

TAX ID # 303.14-2-1

• Curb Box