

LABOR AND MATERIALS


Copper } Connection _____	\$ _____
Lead } _____	
Curb } Cock _____	\$ _____
} Valve _____	in. _____
} T. S. & V. _____	
Service box } Short 3½ x 4½ _____	\$ _____
} Long 4½ x 5½ _____	
Old returned } Buff or Rdway _____	
18 Ft. ¾ in. } Copper _____	\$ _____
} C.I. _____	
} C.I. _____	
} Pipe at _____	
Nipples _____ in. at _____	\$ _____
Bushings _____ to _____ in. at _____	\$ _____
Red'g } _____	
Inc'g } Coupl'gs _____ to _____ in. at _____	\$ _____
Union _____ in. at _____	\$ _____
Meter _____ in. at _____	\$ _____
Lead Joints at _____	\$ _____
Compound Joints at _____	\$ _____
Maintenance Foreman _____	\$ _____
Hrs. Water Maint. Man-1 at _____	\$ _____
Hrs. Water Maint. Man-2 at _____	\$ _____
Hrs. Garage Foreman _____ at _____	\$ _____
Hrs. Labor _____ at _____	\$ _____
Hrs. Compressor at _____	\$ _____
Compensation Ins. at \$ _____ per C _____	\$ _____
Trucking _____	\$ _____
Pav't Patch _____	\$ _____
_____	\$ _____
_____	\$ _____
_____	\$ _____
O'head _____	\$ _____

St. 77
Pl. 77
Ave. No. 77

Name of Owner PLATT

TAX ID # 303.14-3-32

Labor and Mat'l. Report JULY 3 1984

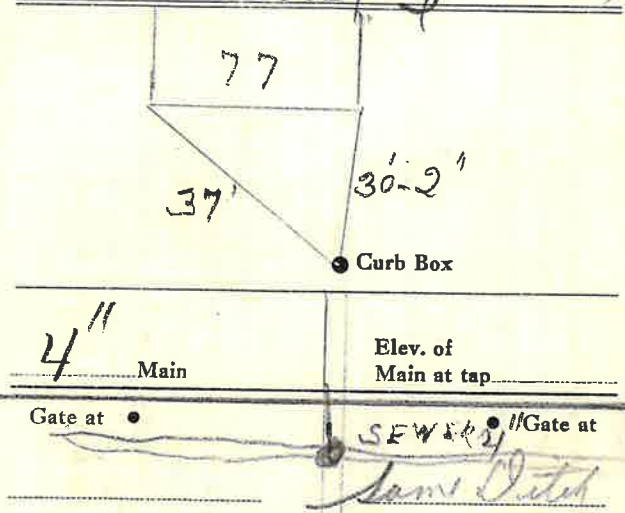

18' to MAIN ● Curb Box
¾" Copper