

LABOR AND MATERIALS


Copper	} Connection	_____	\$ _____		
Lead					
Curb	} Cock	_____ in.	\$ _____		
				} Valve	_____
Service box	} Short 3½ x 4½	_____	\$ _____		
Old returned				} Long 4½ x 5½	_____
Ft. 3/4 in.	} Copper	} Pipe at _____	\$ _____		
				} C.I.	_____
Nipples _____ in.			\$ _____		
Bushings _____ to _____ in.			\$ _____		
Red'g } Inc'g	} Coupl'gs _____ to _____ in.	_____	\$ _____		
Union _____ in.			\$ _____		
Meter _____ in.			\$ _____		
Lead Joints at _____			\$ _____		
Compound Joints at _____			\$ _____		
Maintenance Foreman _____			\$ _____		
Hrs. Water Maint. Man-1 at _____			\$ _____		
Hrs. Water Maint. Man-2 at _____			\$ _____		
Hrs. Garage Foreman _____ at _____			\$ _____		
Hrs. Labor _____ at _____			\$ _____		
Hrs. Compressor at _____			\$ _____		
Compensation Ins. at \$ _____ per C			\$ _____		
Trucking _____			\$ _____		
Pav't Patch _____			\$ _____		
_____			\$ _____		
_____			\$ _____		
_____			\$ _____		
O'head _____			\$ _____		
_____			\$ _____		

Platt

St. _____
 Pl. _____
 Ave. No. 78

Name of Owner _____
TAX ID # 303.14-2-2

Labor and Mat'l. Report _____ 19 86

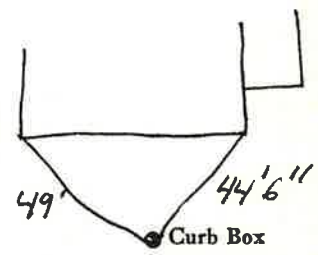

Elev. of
Main at tap _____

Main _____

Gate at • _____ • Gate at _____

• Curb Box