

LABOR AND MATERIALS

1	Copper	Connection	3/4"	\$	2.76
1	Lead	Cock	3/4" in.	\$	3.49
1	Curb	Valve			
		T. S. & V.			
1	Service box	Short	3 1/2 X 4 1/2	\$	4.75
	Old returned	Long	4 1/2 X 5 1/2		
		Buff or Rdway			
22 1/2	3/4" Ft.	Copper	Pipe at 25	\$	7.88
		G. I.			
		C. I.			
	Nipples	in. at		\$	
	Bushings	to in. at		\$	
	Red'g				
	Inc'g	Coupl'gs. to in. at		\$	
	Union	in. at		\$	
	Meter	in. at		\$	
	Lead Joints at			\$	
	Compound Joints at			\$	
2	Hrs. Water Maint. Man	1 at 1.44		\$	2.88
4	Hrs. Water Maint. Man	2 at 1.24		\$	4.96
	Hrs. Labor	at		\$	
20	Hrs. Labor	at 1.13		\$	22.60
1 1/2	Hrs. Compressor at	1 1/2		\$	2.25
	Compensation Ins. at	\$3.706 per C		\$	1.13
	Trucking			\$	1.15
	Pav't Patch			\$	
	Tap by 915501-d			\$	
	7-14-52			\$	
	O'head			\$	
				\$	65.85

53.70

Platt


St. Pl. Ave. No. 80-84

Name of Owner

McGuire

Labor and Mat'l. Report

July 14 1952

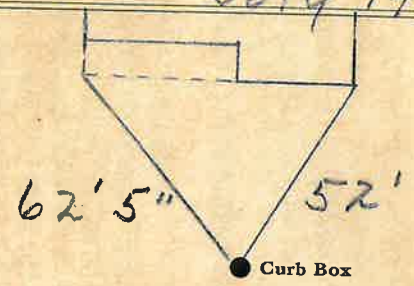

4" Main

Elev. of Main at tap 5'

Gate at ●

● Gate at

22 1/2" to main

3/4" copper

● Curb Box