

LABOR AND MATERIALS


1 Copper } Connection $\frac{3}{4}$ " \$ _____
 Lead }
 1 Curb } Cock } $\frac{3}{4}$ in. \$ _____
 Valve }
 T.S. & V. }
 1 Service box } Short $3\frac{1}{2}$ x $4\frac{1}{2}$ }
 Old returned } Long $4\frac{1}{2}$ x $5\frac{1}{2}$ } \$ _____
 Buff. or Rdway }
 11 Ft. $\frac{3}{4}$ in. } Copper } Pipe at \$ _____
 } G.I. }
 } C.I. }
 Nipples in. at \$ _____
 Bushings to in. at \$ _____
 Red'g }
 Inc'g } Coupl'gs to in. at \$ _____
 Union in. at \$ _____
 Meter in. at \$ _____
 Lead Joints at \$ _____
 Compound Joints at \$ _____
 Maintenance Foreman \$ _____
 Hrs. Water Maint. Man-1 at \$ _____
 Hrs. Water Maint. Man-2 at \$ _____
 Hrs. Garage Foreman at \$ _____
 Hrs. Labor at \$ _____
 Hrs. Compressor at \$ _____
 Compensation Ins. at \$ _____ per C \$ _____
 Trucking \$ _____
 Pav't Patch \$ _____
 Tap by Gissard \$ _____
 I.F. Co. 7-26-61. \$ _____
 O'head \$ _____
 \$ _____

St. 83
 Pt. 85
 Ave. No. 85

Platt

Name of Owner
 Geo. Harrington Jr.

Labor and Mat'l. Report July 26 19 61.

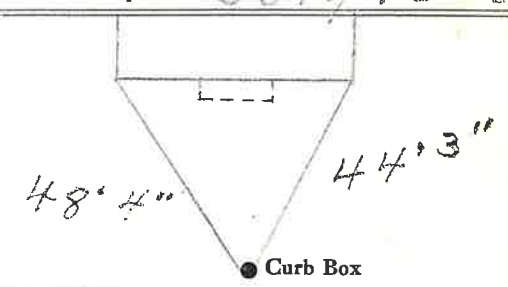

4" Main Elev. of Main at tap 5'

Gate at • Gate at

TAX ID # 303.14-3-30

• Curb Box