

Labor and Materials


Copper } Connection.....	\$.....
Lead } Connection.....	\$.....
Curb { Cock }	in..... \$.....
{ Valve }	in..... \$.....
{ T. S. & V. }	in..... \$.....
Service Box { Short 3 1/2 x 4 1/2 }	\$.....
Old returned { Long 4 1/2 x 5 1/2 }	\$.....
{ Buff. or Rdway }	\$.....
14 3/4 Ft. in. { Copper } Pipe at.....	\$.....
{ Galv. Iron }	\$.....
{ Cast Iron }	\$.....
Nipples..... in. at.....	\$.....
Bushings..... to..... in. at.....	\$.....
Red'g } Couplings..... to..... in. at.....	\$.....
Inc'g } Couplings..... to..... in. at.....	\$.....
Union..... in. at.....	\$.....
Meter..... in. at.....	\$.....
Lbs. Br. Stone at.....	\$.....
Lbs. Sand at.....	\$.....
Bags Cement at.....	\$.....
Paving Brick { Mack } at.....	\$.....
{ Red }	\$.....
{ Asphalt }	\$.....
Lead Joints at.....	\$.....
Leadite Joints at.....	\$.....
Hrs. Foreman at.....	\$.....
Hrs. Common Labor at.....	\$.....
Hrs. Common Labor at.....	\$.....
Hrs. Mason at.....	\$.....
Hrs. Mason's Helper at.....	\$.....
Hrs. Compressor at.....	\$.....
Compensation Ins.....	\$.....
Trucking.....	\$.....
Builders' Use of Water.....	\$.....
Total \$.....	

Platt St.

#95

Labor and Material Report

19

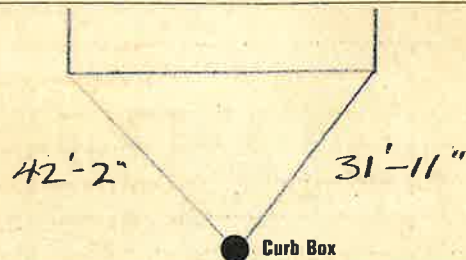

4 Main

Elev. of Main at tap

5'

Gate at

TRAX

•

ID# 303.14-3-13

•

Gate at

● Curb Box

Measured in

4/23/80

M.T.

