

LABOR AND MATERIALS


1	Copper Lead Connection	3/4"	\$	2.76
1	Curb Valve T. S. & V.	3/4 in.	\$	3.49
1	Service box Old returned	Short 3/2 X 4 1/2 Long 4 1/2 X 5 1/2 Buff or Rdway	\$	4.75
22	Ft. 3/4 in. Copper Pipe at	35	\$	7.70
	Nipples	in. at	\$	
	Bushings	to in. at	\$	
	Red'g Inc'g Coupl'gs	to in. at	\$	
	Union	in. at	\$	
	Meter	in. at	\$	
	Lead Joints at		\$	
	Compound Joints at		\$	
2	Hrs. Water Maint. Man-1 at	1.44	\$	2.88
8	Hrs. Water Maint. Man-2 at	1.24	\$	9.92
2.8	Hrs. Labor- at	1.13	\$	3.164
	Hrs. Labor- at		\$	
1 1/2	Hrs. Compressor at	1.50	\$	2.25
	Compensation Ins. at \$	3.706 per C	\$	1.65
	Trucking		\$	1.00
	Pav't Patch		\$	12.83
	Tap by Gifford		\$	
	O'head		\$	

68.04 \$80.87

St. Platt
Pt. 96 & 98
Ave. No. 96 & 98

Name of Owner Maginn

Labor and Mat'l. Report July 14 1952

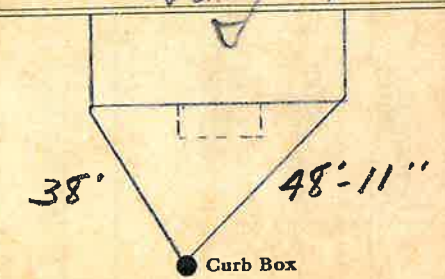

4" Main Elev. of Main at tap 4 1/2'

Gate at ● ● Gate at

● Curb Box

#96 TAX ID # 303.14-2-6