


Labor and Materials

1	Copper	Connection	3	\$ 2.60
1	Lead			
1	Curb	Cock Valve	3	\$ 2.27
1	Service Box	Short 3 1/2 x 4 1/2		
	Old returned	Butt or Rdway		\$ 1.38
2	Pt.	Copper	3/4	\$ 3.75
	in.	Cast Iron		
	Nipples	in. at		\$
	Bushings	to in. at		\$
	Red'g Inc'g	Couplings to in. at		\$
	Union	in. at		\$
	Meter	in. at		\$
	Lbs. Br. Stone	at		\$
	Lbs. Sand	at		\$
	Bags Cement	at		\$
	Paving Brick	Mack Red Asphalt at		\$
	Lead Joints	at		\$
	Leadite Joints	at		\$
5	Hrs. Foreman	at		\$ 3.13
24	Hrs. Common Labor	at		\$ 10.80
	Hrs. Common Labor	at		\$
	Hrs. Mason	at		\$
	Hrs. Mason's Helper	at		\$
	Hrs. Compressor	at		\$
	Compensation Ins			\$ 43
	Trucking			\$ 1 =
	Builders' Use of Water	Patch		\$ 5 =
Total \$				30.39

31-87 100 31
 Labor and Material Report July 28, 1917

74 Platts St 1

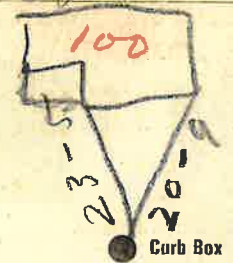

4 Main Eley of Main at tap 4 1/2
 Gate at ● Gate at ●

● Curb Box

Old Tap Shut off

TAX ID # 303.14-2-7