


LABOR AND MATERIALS

1	Copper	} Connection	$\frac{3}{4}$ "		\$
	Lead				
1	Curb	{ Cock	$\frac{3}{4}$ in.		\$
		Valve			
		T. S. & V.			
1	Service box	{ Short $3\frac{1}{2} \times 4\frac{1}{2}$			
	Old returned	Long $4\frac{1}{2} \times 5\frac{1}{2}$			
		Buff or Rdway			\$
23	Ft.	{ Copper	$\frac{3}{4}$ in.		
		G.I.			
		C.I.			
		Pipe at			\$
	Nipples	in. at			\$
	Bushings	to in. at			\$
	Red'g	} Coupl'gs	to in. at		
	Inc'g				
	Union	in. at			\$
	Meter	in. at			\$
	Lead Joints at				\$
	Compound Joints at				\$
	Maintenance Foreman				\$
	Hrs. Water Maint. Man-1 at				\$
	Hrs. Water Maint. Man-2 at				\$
	Hrs. Garage Foreman at				\$
	Hrs. Labor- at				\$
	Hrs. Compressor at				\$
	Compensation Ins. at \$	per C			\$
	Trucking				\$
	Pav't Patch				\$
	Tap by Gifford & Co.				\$
	Apr. 30-65.				\$
	O'head				\$
					\$

St.
Pl.
Ave. No. 104

Name of Owner
Platt
Leonard Shaw.

Labor and Mat'l. Report Apr. 30 1965

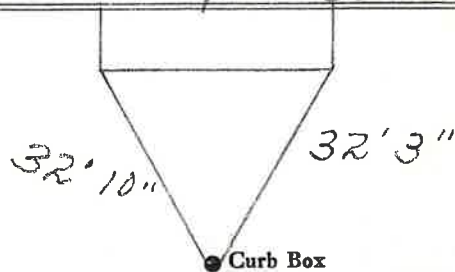

6" Main Elev. of Main at tap 4'

Gate at • • Gate at

TAX ID# 303.14-2-8

• Curb Box