


LABOR AND MATERIALS

1	Copper	Connection	3/4"	\$	2.71
1	Lead	Cock	3/4 in.	\$	3.83
1	Curb	Valve	3/4 in.	\$	3.83
		F.S. & V.			
1	Service box	Short 3 1/2 x 4 1/2		\$	4.69
	Old returned	Long 4 1/2 x 5 1/2		\$	
		Buff or Rdway		\$	
8	Ft.	Copper	Pipe at 45	\$	3.60
		G.I.			
		G.I.			
	Nipples	in. at		\$	
	Bushings	to in. at		\$	
	Red'g			\$	
	Inc'g	Coupl'gs to in. at		\$	
	Union	in. at		\$	
	Meter	in. at		\$	
	Lead Joints at			\$	
	Compound Joints at			\$	
	Maintenance Foreman			\$	
	Hrs. Water Maint. Man-1 at			\$	
2	Hrs. Water Maint. Man-2 at	1.24		\$	2.48
	Hrs. Garage Foreman at			\$	
4	Hrs. Labor at	1.13		\$	4.52
	Hrs. Compressor at			\$	
	Compensation Ins. at \$	4.29 per C		\$	1.30
	Trucking			\$	1.50
	Pay't Patch			\$	10.80
	Tap by Giggord 5-16-55			\$	
	O'head			\$	
				\$	34.43

St. Platt
~~Pl.~~
 Ave. No. 105

Name of Owner Sassone

Labor and Mat'l. Report May 16 1955

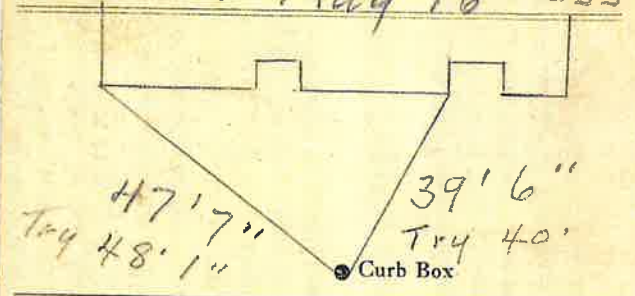

6" Main Elev. of Main at tap 4'

Gate at • Gate at

TAX ID # 303.14-3-5

• Curb Box