

Labor and Materials


1	Copper	Connection	3	\$ 2.60
1	Lead	in	2	\$ 2.30
1	Curb	Cock Valve & V.	1	\$ 1.40
1	Service Box	Short 3/4 x 1 1/2	3	\$ 1.86
	Old returned	Long 1 1/2 x 5 1/2	1	
		Butt. or Rdway	1	
7	Ft.	Copper	3	\$ 1.86
	in.	Galv. Iron	1	
		Pipe at	1	
	Nipples	in. at		\$
	Bushings	to in. at		\$
	Red'g	Couplings		\$
	Inc'g	to in. at		\$
	Union	in. at		\$
	Meter	in. at		\$
	Lbs. Br. Stone	at		\$
	Lbs. Sand	at		\$
	Bags Cement	at		\$
	Paving Brick	Mack Red Asphalt		\$
	Lead Joints	at		\$
	Leadite Joints	at		\$
4	Hrs. Foreman	at		\$ 2.50
16	Hrs. Common Labor	at		\$ 6.50
	Hrs. Common Labor	at		\$
	Hrs. Mason	at		\$
	Hrs. Mason's Helper	at		\$
	Hrs. Compressor	at		\$
	Compensation Ins.			\$.24
	Trucking			\$ 1.00
	Builders' Use of Water	patch		\$ 5.00
Total \$				23.40

79-178 12
Labor and Material Report

Apr. 27 19

8 Clatter St.

28' 11"

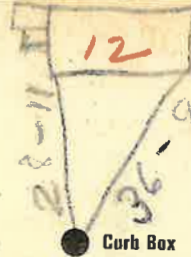

Curb Box

Main

Elev of Main at tap 5

Gate at ●

● Gate at

● Curb Box

Old tap dis-connected

TAX ID# 303.18-12-2