

LABOR AND MATERIALS


1	Copper } Connection	3/4"	\$
	Lead }		
1	Curb } Cock Valve	3/4" in.	\$
		T.S. & V.	
Same	Service Box	{ Short 3 1/2 x 4 1/2	\$
	Old returned	{ Long 4 1/2 x 5 1/2	
		{ Buffer Rdway	
25	Ft. 3/4 in.	{ Copper	\$
		{ Galv Iron	
		{ Cast Iron	
	Nipples	in. at	\$
	Bushings	to in. at	\$
	Red'g } Couplings	to in. at	\$
	Inc'g }		
	Union	in. at	\$
	Meter	in. at	\$
	Lead Joints at		\$
	Leadite Joints at		\$
	Hrs. Foreman at		\$
	Hrs. Chauffeur at		\$
	Hrs. Tapper at		\$
	Hrs. Labor at		\$
	Hrs. Labor at		\$
	Hrs. Compressor at		\$
	Compensation Ins.		\$
	Trucking		\$
	Builders Use of Water		\$
Tap by Kelly			
Miller & Co.			
10-6-60			

Platts

St. 110
Pl. 82
Ave. No. 82

Name of Owner
Anthony J. Delisle

Labor and Mat'l. Report Oct. 6 1960

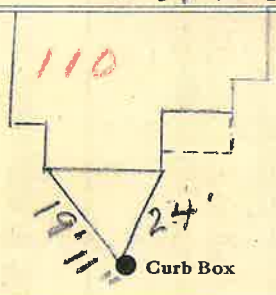

6" Main Elev. of Main at tap 3'

Gate at ● ● Gate at

TAX ID# 303.14-2-11

● Curb Box