

LABOR AND MATERIALS

Copper	} Connection	_____	\$ _____	
Lead				
Curb	} Cock	_____ in.	\$ _____	
				} Valve
Service box	} Short 3½ x 4½	_____	\$ _____	
Old returned				Long 4½ x 5½
25 Ft. ¾ in.	} Copper	_____	\$ _____	

Nipples	_____ in. at _____	\$ _____		
Bushings	_____ to _____ in. at _____	\$ _____		
Red'g	} Coupl'gs _____ to _____ in. at _____	\$ _____		
Inc'g				
Union	_____ in. at _____	\$ _____		
Meter	_____ in. at _____	\$ _____		
Compound Joints	_____ at _____	\$ _____		
Maintenance Foreman	_____	\$ _____		
Hrs. Water Maint. Man—1	at _____	\$ _____		
Hrs. Water Maint. Man—2	at _____	\$ _____		
Hrs. Garage Foreman	at _____	\$ _____		
Hrs. Labor—	at _____	\$ _____		
Hrs. Compressor	at _____	\$ _____		
Trucking	_____	\$ _____		
Pav't Patch	_____	\$ _____		
		\$ _____		
		\$ _____		
PLATT


St. No. 114

Name of Owner

GIRARD

Labor and Mat'l. Report

1999

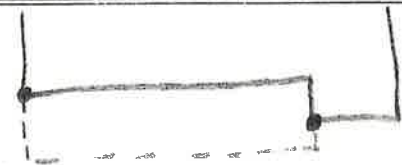

● Curb Box

6" Main

Elev. of Main at tap 4½'

Gate at ●

● Gate at

TAX ID# 303.14-2-12.2

● Curb Box