


LABOR AND MATERIALS

Copper } Connection _____	\$ _____
Lead } _____	\$ _____
Curb } Cock } _____ in.	\$ _____
} Valve } _____	
} T. S. & V. } _____	
Service box } Short 3 1/2 x 4 1/2 }	
Old returned } Long 4 1/2 x 5 1/2 }	\$ _____
Ft. 3/4 in. } Copper } Pipe at _____	\$ _____
} C.I. }	
} C.I. }	
Nipples _____ in. at _____	\$ _____
Bushings _____ to _____ in. at _____	\$ _____
Red'g } Coupl'gs _____ to _____ in. at _____	\$ _____
Inc'g } _____	
Union _____ in. at _____	\$ _____
Meter _____ in. at _____	\$ _____
_____	\$ _____
Compound Joints at _____	\$ _____
Maintenance Foreman _____	\$ _____
Hrs. Water Maint. Man-1 at _____	\$ _____
Hrs. Water Maint. Man-2 at _____	\$ _____
Hrs. Garage Foreman _____ at _____	\$ _____
Hrs. Labor _____ at _____	\$ _____
Hrs. Compressor at _____	\$ _____
_____	\$ _____
Trucking _____	\$ _____
Pav't Patch _____	\$ _____
_____	\$ _____
_____	\$ _____
_____	\$ _____
_____	\$ _____

UPPER APT. HOUSE - FOOT OF HILL
 PLATT St. No. 118

Name of Owner
 KEN WHITING

Labor and Mat'l. Report 19 86

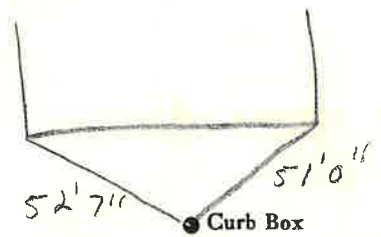

Main Elev. of Main at tap
 Gate at • Gate at

TAX ID # 303.14-1-8

• Curb Box

TAP IN DRIVEWAY

LSM-5C-6-1-67 3/4" copper