

9 6 1941

Platt


St. 13
-Pt-
Ave. No. 9

Name of Owner

Hot Tap

Labor and Mat'l. Report

Aug 8 1941

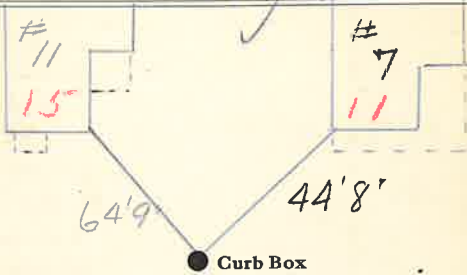

4 Main

Elev. of Main at tap... 6

Gate at ●

● Gate at

● Curb Box

PLATT


St. 13
-Pt-
Ave. No. 13

Name of Owner

TAX ID # 303.18-13-9

Labor and Mat'l. Report

1989

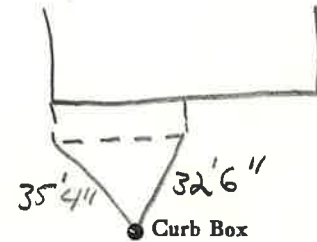

Main

Elev. of Main at tap

Gate at ●

● Gate at

● Curb Box

RENEWAL TAP

