

**Labor and Materials**

Copper } Connection. <sup>3/4"</sup>	\$ 1.33
Lead } Connection. <sup>3/4"</sup>	
Curb { Cock Valve } <sup>3/4"</sup> in	\$ 58
Service Box { Short 6 1/2 x 4 1/2 } Old returned { Long 4 1/2 x 5 1/2 } { Buff. or Redway }	\$ 1.36
23 Ft. <sup>3/4"</sup> in. { Copper } { Galv. Iron } Pipe at	\$ 2.18
{ Cast Iron }	
Nipples ..... in. at	\$
Bushings ..... to ..... in. at	\$
Red'g } Couplings..... to ..... in. at	\$
Inc'g }	
Union..... in. at	\$
Meter..... in. at	\$
Lbs. Br. Stone at	\$
Lbs. Sand at	\$
Bags Cement at	\$
Paving Brick { Mack } { Red } at	\$
{ Asphalt }	
Lead Joints at	\$
Leadite Joints at	\$
1 Hrs. Foreman at	\$ .63
Hrs. Common Labor at	\$
8 Hrs. Common Labor at 40	\$ 3.20
Hrs. Mason at	\$
Hrs. Masons Helper at	\$
Hrs. Compressor at	\$
Compensation Ins	\$ 1.12
Trucking	\$ 1.00
Builders Use of Water <sup>patch</sup>	\$

Total \$ 11.40


33-42

#1 of 2

Labor and Material Report

1933

3/4" top on Pipe at H. Warner

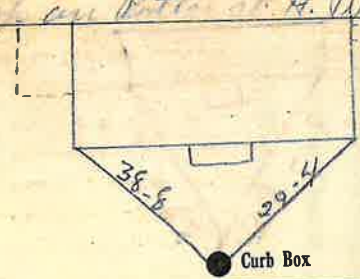

6" Main

Elev. of Main at tap 472

Gate at ●

● Gate at

#2 TAX ID # 302.12-14-1

New House

Robt. J. Nolan

3/4" COPPER  
23' to MAIN

*(Signature)*