

### LABOR AND MATERIALS


1	Copper Lead	Connection	<u>3/4"</u>		\$ 2.71
1	Curb	Cock Valve T. S. & V.	3/4 in.		\$ 3.83
1	Service box Old returned	Short 3 1/2 x 4 1/2 Long 4 1/2 x 5 1/2 Buff or Rdway			\$ 4.69
10	Ft.	Copper G.I. G.I.	3/4 in.	45	\$ 4.50
	Nipples	in. at			\$
	Bushings	to in. at			\$
	Red'g Inc'g	Coupl'gs	to in. at		\$
	Union	in. at			\$
	Meter	in. at			\$
	Lead Joints at				\$
	Compound Joints at				\$
	Maintenance Foreman				\$
	Hrs. Water Maint. Man-1 at				\$
	Hrs. Water Maint. Man-2 at				\$
3	Hrs. Garage Foreman	at	1.59		\$ 4.77
	Hrs. Labor	at			\$
	Hrs. Compressor at				\$
	Compensation Ins. at	\$ 4.24	per C		\$ 20
	Trucking				\$ 1.50
	Pav't Patch				\$ 8.10
	Tap by Larreau 4-28-55				\$
	O'head				\$
					\$ 30.30

St.  
Pt.  
Ave. No. 7

Potter  
Name of Owner

Bonacker

Labor and Mat'l. Report April 28 1955

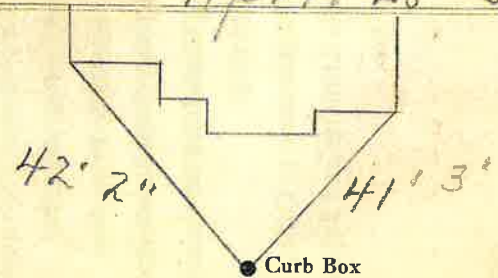

6" Main Elev. of Main at tap 4 1/2'

Gate at • • Gate at  
TAX ID# 302.12-15.9

• Curb Box

3/4" COPPER  
10' to MAIN