

LABOR AND MATERIALS

1	Copper Lead	Connection	3/4"	\$
1	Curb	Cock Valve T.S. & V.	3/4 in.	\$
1	Service box	Short 3 1/2 x 4 1/2 Long 4 1/2 x 5 1/2 Buff. or Rdway		\$
	Old returned			
9	Ft.	Copper G.I. C.I.	3/4 in. } Pipe at	\$
	Nipples	in. at		\$
	Bushings	to in. at		\$
	Red'g Inc'g	Coupl'gs	to in. at	\$
	Union	in. at		\$
	Meter	in. at		\$
	Lead Joints	at		\$
	Compound Joints	at		\$
	Maintenance Foreman			\$
	Hrs. Water Maint. Man	1 at		\$
	Hrs. Water Maint. Man	2 at		\$
	Hrs. Garage Foreman	at		\$
	Hrs. Labor	at		\$
	Hrs. Compressor	at		\$
	Compensation Ins.	at \$ per C		\$
	Trucking			\$
	Pav't Patch			\$
	Tap by Gifford & Co. 6-12-61.			\$
	O'head			\$

Potter


St. ~~Pl.~~ Ave. No. 9

Name of Owner

John J. Edie

Labor and Mat'l. Report

June 12 1961.

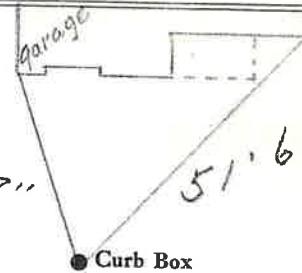

● Curb Box

6" C.I.
Main

Elev. of
Main at tap 5'

Gate at ●

● Gate at

TAX ID# 302.12-15.8

● Curb Box

3/4" copper
9' to main