


## LABOR AND MATERIALS

1	Copper	Connection	3/4"		\$ 2.76
	<del>Lead</del>				
1	Curb	Cock Valve	3/4" in.		\$ 3.49
		T. S. & V.			
1	Service box	Short 3/4 X 4 1/2			
	Old returned	Long 4 1/2 X 5 1/2			\$ 4.75
		Buff or Rd way			
9	Ft.	Copper	3/4" in.	35	\$ 31.5
		C.I.			
		Pipe at			
	Nipples	in. at			\$
	Bushings	to in. at			\$
	Red'g				\$
	Inc'g	Coupl'gs. to in. at			\$
	Union	in. at			\$
	Meter	in. at			\$
	Lead Joints	at			\$
	Compound Joints	at			\$
6	Hrs. Water Maint. Man-1	at	1.34		\$ 8.04
	Hrs. Water Maint. Man-2	at			\$
17	Hrs. Labor-	at	1.13		\$ 19.21
	Hrs. Labor-	at			\$
1	Hrs. Compressor	at			\$ 1.50
	Compensation Ins.	at \$3.706 per C			\$ 1.01
	Trucking				\$ 1.00
	Pav't Patch				\$ 5.40
					\$
					\$
					\$
					\$
	O'head				\$
	Tap by Warsinski				\$ 50.31
	6-24-52				
	4491				

St. \_\_\_\_\_  
 Pt. \_\_\_\_\_  
 Ave. No. 38

Name of Owner Prospect  
Duggan

Labor and Mat'l. Report JUNE 24 1952

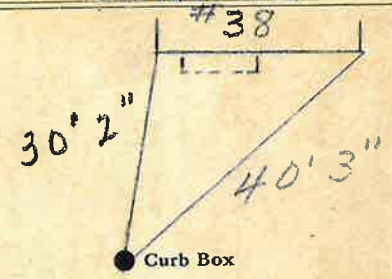

4" Main Elev. of Main at tap 4'

Gate at ● ● Gate at

TAX ID# 303.17-14-5

● Curb Box

3/4" COPPER  
 9' to MAIN