

**LABOR AND MATERIALS**

Copper } Connection \_\_\_\_\_ \$ \_\_\_\_\_  
 Lead }  
 Curb } Cock \_\_\_\_\_ in. \_\_\_\_\_ \$ \_\_\_\_\_  
 } Valve }  
 } T.S. & V. }  
 Service box { Short 3-1/2 x 4-1/2 } \_\_\_\_\_ \$ \_\_\_\_\_  
 Old returned { Long 4-1/2 x 5-1/2 }  
 Ft. \_\_\_\_\_ in. { Copper } Pipe at \_\_\_\_\_ \$ \_\_\_\_\_  
 } G.I. }  
 } C.I. }  
 Nipples \_\_\_\_\_ in. at \_\_\_\_\_ \$ \_\_\_\_\_  
 Bushings \_\_\_\_\_ to \_\_\_\_\_ in. at \_\_\_\_\_ \$ \_\_\_\_\_  
 Red'g \_\_\_\_\_  
 Inc'g \_\_\_\_\_  
 Union \_\_\_\_\_ in. at \_\_\_\_\_ \$ \_\_\_\_\_  
 Meter \_\_\_\_\_ in. at \_\_\_\_\_ \$ \_\_\_\_\_  
 \_\_\_\_\_ \$ \_\_\_\_\_  
 Compound Joints at \_\_\_\_\_ \$ \_\_\_\_\_  
 Maintenance Foreman \_\_\_\_\_ \$ \_\_\_\_\_  
 Hrs. Water Maint. Man - 1 at \_\_\_\_\_ \$ \_\_\_\_\_  
 Hrs. Water Maint. Man - 2 at \_\_\_\_\_ \$ \_\_\_\_\_  
 Hrs. Garage Foreman \_\_\_\_\_ at \_\_\_\_\_ \$ \_\_\_\_\_  
 Hrs. Labor \_\_\_\_\_ at \_\_\_\_\_ \$ \_\_\_\_\_  
 Hrs. Compressor at \_\_\_\_\_ \$ \_\_\_\_\_  
 \_\_\_\_\_ \$ \_\_\_\_\_  
 Trucking \_\_\_\_\_ \$ \_\_\_\_\_  
 Pav't Patch \_\_\_\_\_ \$ \_\_\_\_\_  
 \_\_\_\_\_ \$ \_\_\_\_\_  
 \_\_\_\_\_ \$ \_\_\_\_\_  
 \_\_\_\_\_ \$ \_\_\_\_\_  
 \_\_\_\_\_ \$ \_\_\_\_\_

PROSPECT


St. Pl. Ave. No. 46

Name of Owner

CREATED By Tony MISSITA

Labor and Mat'l. Report 19

MAY of 2003

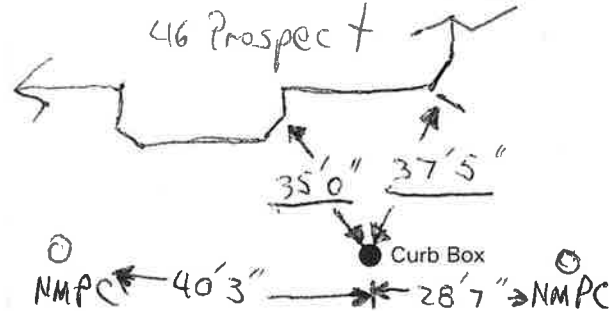

\_\_\_\_\_ Main Elev. of Main at tap \_\_\_\_\_

Gate at ● ● Gate at

TAX ID# 303.17-5-1

● Curb Box

### Labor and Materials

Lead	Copper Connection	3/4	\$ 2.60
1	Curb	Cock Valve T.S. & V. 3/4	\$ 2.30
1	Service Box Old returned	Short 3/4x1/2 Long 1/2x3/4 Buff. or Rdway	\$ 1.40
6	Ft. 3/4 in.	Copper Galv. Iron Pipe at	\$ 2.12
1	Nipples	in. at	\$
	Bushings	to in. at	\$
	Red'g Inc'g	Couplings to in. at	\$
	Union	in. at	\$
	Meter	in. at	\$
	Lbs. Br. Stone	at	\$
	Lbs. Sand	at	\$
	Bags Cement	at	\$
	Paving Brick	Mack Red Asphalt at	\$
	Lead Joints	at	\$
	Leadite Joints	at	\$
4	Hrs. Foreman	at	\$ 2.50
27	Hrs. Common Labor	at	\$ 10.97
	Hrs. Common Labor	at	\$
	Hrs. Mason	at	\$
	Hrs. Mason's Helper	at	\$
	Hrs. Compressor	at	\$
	Compensation Ins		\$ 36
	Trucking		\$ 1.00
	Builders' Use of Water	Patch	\$ 5.00
	Total		\$ 28.25

29-203 46 Nov 17 1929

Labor and Material Report

36 Prospect St



Lawrence St

Curb Box

12"

Main

Elev of Main at tap

6 1/2

Gate at

TAX 10# 303.17-5-1

Gate at

Curb Box

Tap in from  
Lawrence St  
~~old tap to be dug~~  
~~tap~~ changed  
over 11-10-54.