


LABOR AND MATERIALS

Copper	}	Connection			\$	
Lead						
Curb	}	Cock Valve T. S. & V.			\$	
Service Box			}	Short 3/2x4 1/2		\$
Old returned					Long 4 1/2x5 1/2	
		Buff. or Rdway		\$		
12 Ft. 3/4 in.	}	Copper Galv Iron Cast Iron			\$	
			}	Pipe at		\$
Nipples		in. at		\$		
Bushings		to in. at		\$		
Red'g Inc'g	}	Couplings			\$	
			to in. at		\$	
Union		in. at		\$		
Meter		in. at		\$		
Lead Joints		at		\$		
Leadite Joints		at		\$		
Hrs. Foreman		at		\$		
Hrs. Chauffeur		at		\$		
Hrs. Tapper		at		\$		
Hrs. Labor		at		\$		
Hrs. Labor		at		\$		
Hrs. Compressor		at		\$		
Compensation Ins.				\$		
Trucking				\$		
Builders Use of Water				\$		
				\$		
				\$		
				\$		
				\$		

13-26
St. 50
Pt. 38
Ave. No. 38

Name of Owner
Powers

Labor and Mat'l. Report 4-8-36 19

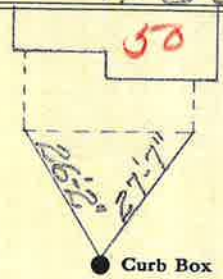

6" Main Elev. of Main at tap 5'

Gate at ● ● Gate at

TAX ID # 303.17-5-2

● Curb Box

Old Shut Off.
3/4" copper
12' to main