

LABOR AND MATERIALS


Copper } Connection \_\_\_\_\_ \$ \_\_\_\_\_  
 Lead }  
 Curb } Cock } \_\_\_\_\_ in. \$ \_\_\_\_\_  
       } Valve }  
       } T. S. & V. }  
 Service box { Short 3½ x 4½ }  
 Old returned { Long 4½ x 5½ }  
               { Buff or Rdway } \_\_\_\_\_ \$ \_\_\_\_\_  
 Ft. \_\_\_\_\_ in. { Copper } Pipe at \_\_\_\_\_ \$ \_\_\_\_\_  
                       { G. I. }  
                       { C. I. }  
 Nipples \_\_\_\_\_ in. at \_\_\_\_\_ \$ \_\_\_\_\_  
 Bushings \_\_\_\_\_ to \_\_\_\_\_ in. at \_\_\_\_\_ \$ \_\_\_\_\_  
 Red'g }  
 Inc'g } Coupl'gs \_\_\_\_\_ to \_\_\_\_\_ in. at \_\_\_\_\_ \$ \_\_\_\_\_  
 Union \_\_\_\_\_ in. at \_\_\_\_\_ \$ \_\_\_\_\_  
 Meter \_\_\_\_\_ in. at \_\_\_\_\_ \$ \_\_\_\_\_  
 Lead Joints at \_\_\_\_\_ \$ \_\_\_\_\_  
 Compound Joints at \_\_\_\_\_ \$ \_\_\_\_\_  
 Maintenance Foreman \_\_\_\_\_ \$ \_\_\_\_\_  
 Hrs. Water Maint. Man—1 at \_\_\_\_\_ \$ \_\_\_\_\_  
 Hrs. Water Maint. Man—2 at \_\_\_\_\_ \$ \_\_\_\_\_  
 Hrs. Garage Foreman \_\_\_\_\_ at \_\_\_\_\_ \$ \_\_\_\_\_  
 Hrs. Labor— \_\_\_\_\_ at \_\_\_\_\_ \$ \_\_\_\_\_  
 Hrs. Compressor at \_\_\_\_\_ \$ \_\_\_\_\_  
 Compensation Ins. at \$ \_\_\_\_\_ per C \_\_\_\_\_ \$ \_\_\_\_\_  
 Trucking \_\_\_\_\_ \$ \_\_\_\_\_  
 Pav't Patch \_\_\_\_\_ \$ \_\_\_\_\_  
 \_\_\_\_\_ \$ \_\_\_\_\_  
 \_\_\_\_\_ \$ \_\_\_\_\_  
 \_\_\_\_\_ \$ \_\_\_\_\_  
 \_\_\_\_\_ \$ \_\_\_\_\_  
 O'head \_\_\_\_\_ \$ \_\_\_\_\_  
 \_\_\_\_\_ \$ \_\_\_\_\_

St. \_\_\_\_\_  
 Pt. \_\_\_\_\_  
 Prospect \_\_\_\_\_  
 Ave. No. 27

Name of Owner \_\_\_\_\_

TAX ID# 303.17-15-14

Labor and Mat'l. Report July 15 19 81

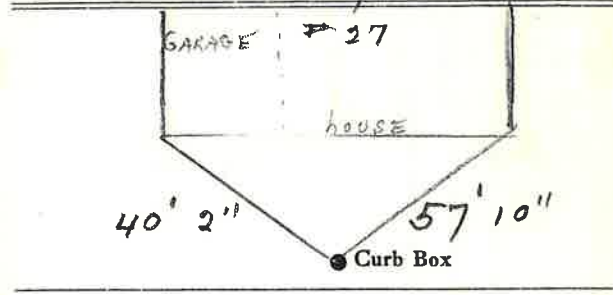

Main \_\_\_\_\_ Elev. of Main at tap \_\_\_\_\_  
 Gate at • \_\_\_\_\_ Gate at \_\_\_\_\_

• Curb Box