


Labor and Materials

Copper } Connection.....	\$ 1.33
Lead }
Curb { Cock Valve T.S.&V. }	\$ 1.58
Service Box { Short 3 1/2 x 4 1/2 }	\$ 1.36
Old returned { Long 4 1/2 x 5 1/2 }
13 Ft. 2 in. { Copper Galv. Iron Cast Iron } Pipe at	\$ 1.23
Nipples
Bushings
Red'g Inc'g } Couplings.....
Union.....
Meter.....
Lbs. Br. Stone at
Lbs. Sand at
Bags Cement at
Paving Brick { Mack Red Asphalt } at
Lead Joints at
Leadite Joints at
A Hrs. Foreman at	\$ 2.50
Hrs. Common Labor at
16 Hrs. Common Labor at	\$ 7.20
Hrs. Mason at
Hrs. Masons Helper at
Hrs. Compressor at
Compensation Ins	\$ 1.30
Trucking	\$ 1.00
Builders Use of Water Patch	\$ 5.00
Total \$ 21.50	

42 Prospect St

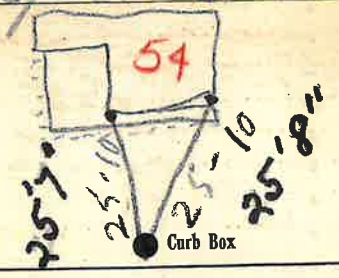

6 Main Elev. of Main at tap

Gate at 13' to main Gate at

3/4" copper Curb Box

Old Tap shut off at main

3/4" copper
13' to MAIN
TAX ID # 303.17-5-4

OK