

LABOR AND MATERIALS

Copper	} Connection	_____	\$ _____		
Lead					
Curb	} Cock Valve T. S. & V. }	_____ in.	\$ _____		
				Service box	} Short 3 1/2 x 4 1/2 }
13 Ft. 3/4 in.	} Copper C.I. C.I. }	Pipe at	\$ _____		
Nipples _____ in.		at	\$ _____		
Bushings _____ to _____ in.		at	\$ _____		
Red'g } Inc'g }	} Coupl'gs.	_____ to _____ in.	at \$ _____		
Union _____ in.				at \$ _____	
Meter _____ in.	at	\$ _____			
_____			\$ _____		
Compound Joints	at		\$ _____		
Maintenance Foreman			\$ _____		
Hrs. Water Maint. Man—1	at		\$ _____		
Hrs. Water Maint. Man—2	at		\$ _____		
Hrs. Garage Foreman	at		\$ _____		
Hrs. Labor—	at		\$ _____		
Hrs. Compressor	at		\$ _____		
_____			\$ _____		
Trucking			\$ _____		
Pav't Patch			\$ _____		
_____			\$ _____		
_____			\$ _____		
_____			\$ _____		
_____			\$ _____		


PROSPECT

St. ~~Pl.~~
Ave. No. 56

Name of Owner _____

Labor and Mat'l. Report

19

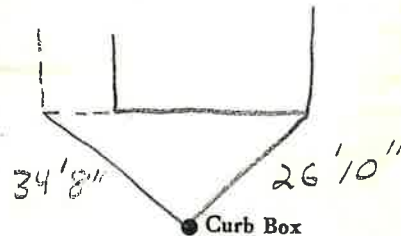

_____ Main Elev. of
Main at tap _____

Gate at • • Gate at

TAX ID # 303.17-5-5

• Curb Box

2 BOXES AT THIS
ADDRESS - OLD BUFFALO BOX
DISCONTINUED

LSM 5C-6.1.67

3/4" COPPER

13' to MAIN