

LABOR AND MATERIALS


| | |
|--|-----------|
| Copper } Connection _____ | \$ _____ |
| Lead } _____ | \$ _____ |
| Curb } Cock _____ | \$ _____ |
| } Valve _____ | in. _____ |
| } T. S. & V. _____ | \$ _____ |
| Service box } Short 3½ x 4½ } _____ | \$ _____ |
| Old returned } Long 4½ x 5½ } _____ | \$ _____ |
| 29'6" Ft. ¾ in. } Copper } Pipe at _____ | \$ _____ |
| } G.I. } _____ | \$ _____ |
| } G.I. } _____ | \$ _____ |
| Nipples _____ in. at _____ | \$ _____ |
| Bushings _____ to _____ in. at _____ | \$ _____ |
| Red'g } _____ | \$ _____ |
| Inc'g } Coupl'gs _____ to _____ in. at _____ | \$ _____ |
| Union _____ in. at _____ | \$ _____ |
| Meter _____ in. at _____ | \$ _____ |
| _____ | \$ _____ |
| Compound Joints at _____ | \$ _____ |
| Maintenance Foreman _____ | \$ _____ |
| Hrs. Water Maint. Man—1 at _____ | \$ _____ |
| Hrs. Water Maint. Man—2 at _____ | \$ _____ |
| Hrs. Garage Foreman _____ at _____ | \$ _____ |
| Hrs. Labor— _____ at _____ | \$ _____ |
| Hrs. Compressor at _____ | \$ _____ |
| _____ | \$ _____ |
| Trucking _____ | \$ _____ |
| Pav't Patch _____ | \$ _____ |
| _____ | \$ _____ |
| _____ | \$ _____ |
| _____ | \$ _____ |
| _____ | \$ _____ |

St. ~~St.~~ Ave. No. 61

PROSPECT
Name of Owner

SULETTE

Labor and Mat'l. Report 1996

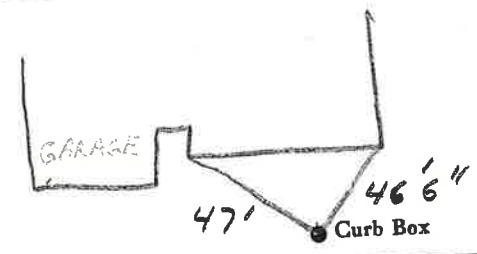

4" Main Elev. of Main at tap 5'

Gate at • Gate at •

TAX ID # 303.17-6-11

• Curb Box

¾" COPPER
29'6" TO MAIN