




2 1/4" top of 50' Product m

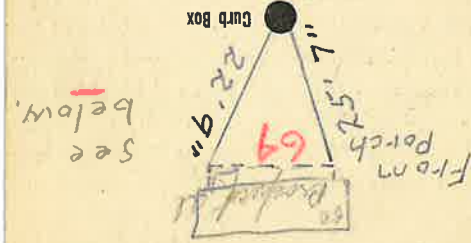

TRX ID# 303.17-5.8

4" Main Elev. of Main at tap 5 ft

Gate at 3/4" copper 11' to main Gate at

